






BEARS

SEASON 4
EPISODE 7



INT. FRANKS HALLWAY AND BEDROOM

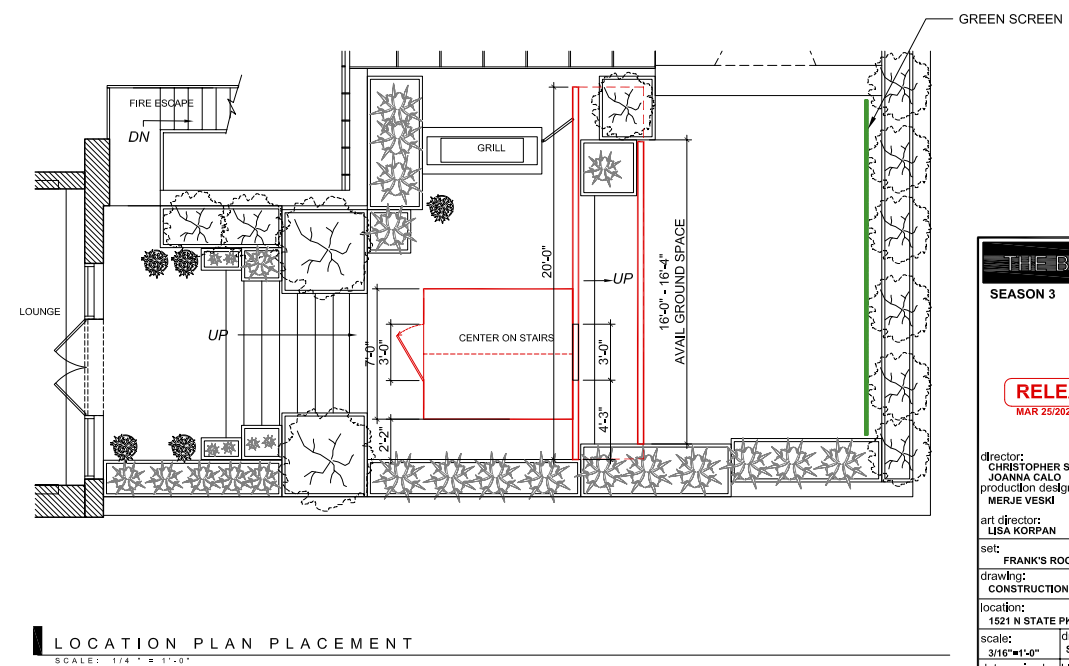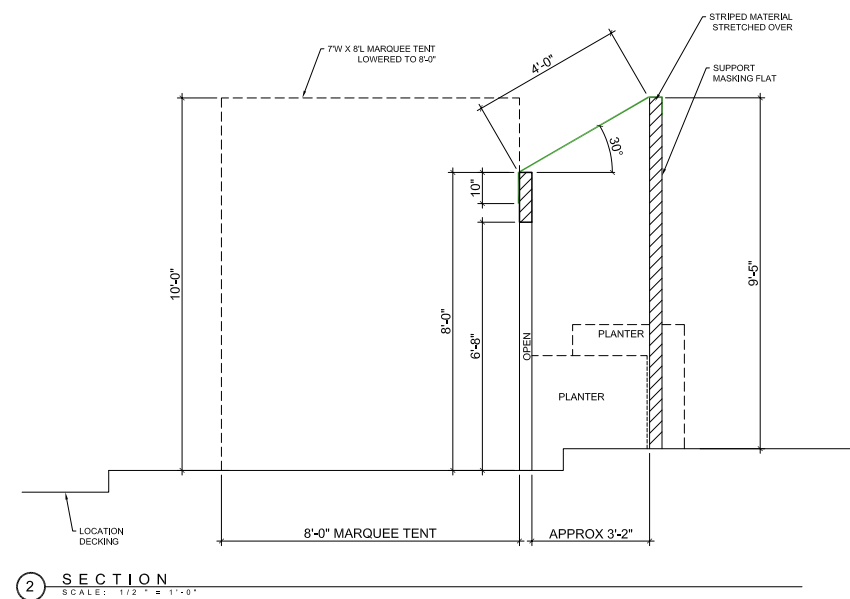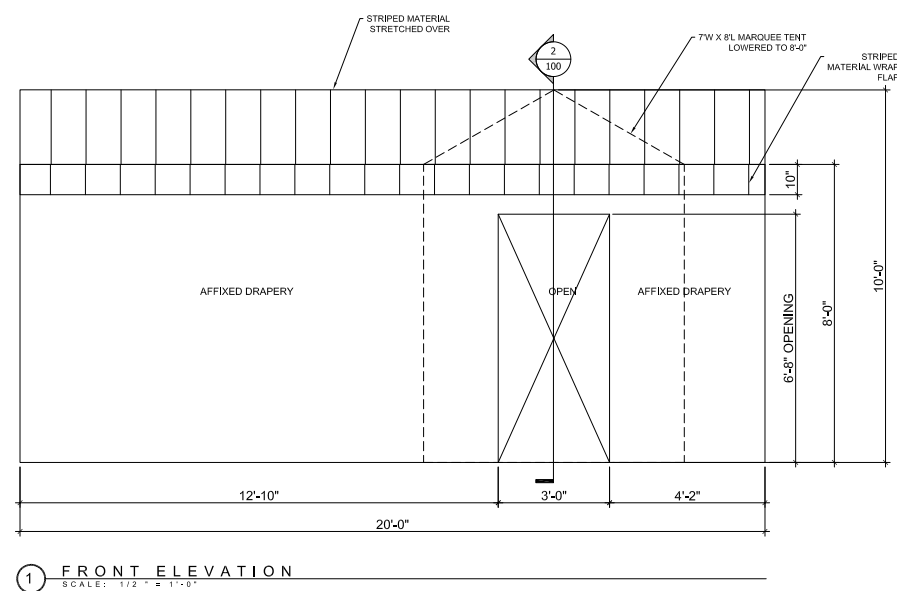


THE BEAR SEASON 3	
RELEASED MAR 25 2024	
director: CHRISTOPHER STORER JOANNA CALO production designer: MERLIE VESID	
art director: LISA KORPAN	
set: FRANK'S ROOF (TENT)	
drawing: CONSTRUCTION INSTALL	
location: 1521 N STATE PKWY	
scale: 3/16"=1'-0"	drawn by: SHANE C
date revised: 03.25.2024	block: --
set no:	sheet no:
404-42	100



INT./ EXT. FRANK'S LIVING ROOM AND OUTSIDE OF TENT



EXT . FRANKS TENT

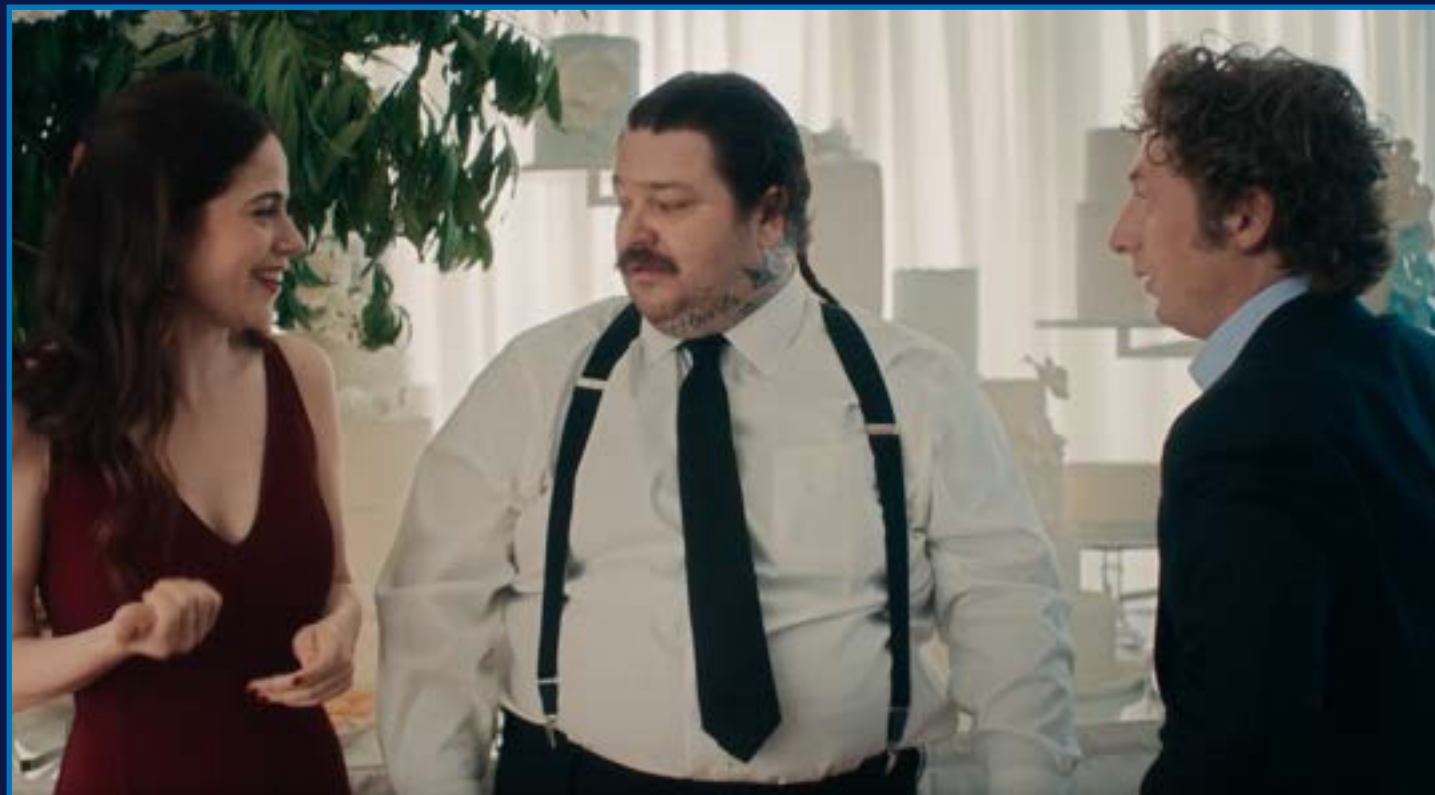
















SET RENDERINGS

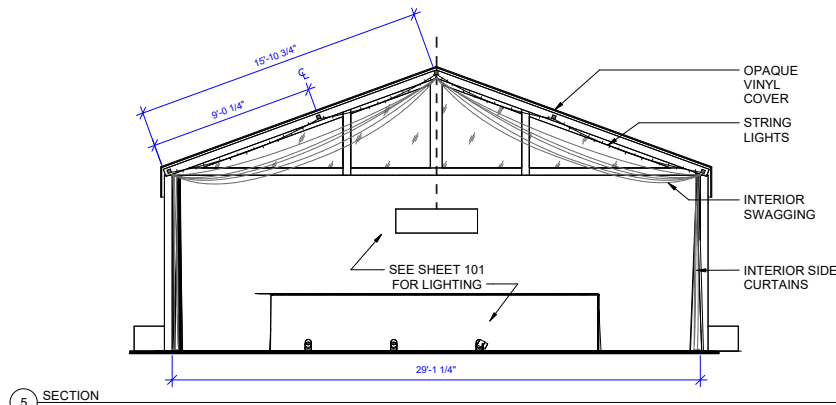


Roof Live Load
Concentrated Hanging Loads:
250 pounds hung from the 1/4 points of the rafter frame
250 pounds hung from the midpoint of the rafter frame

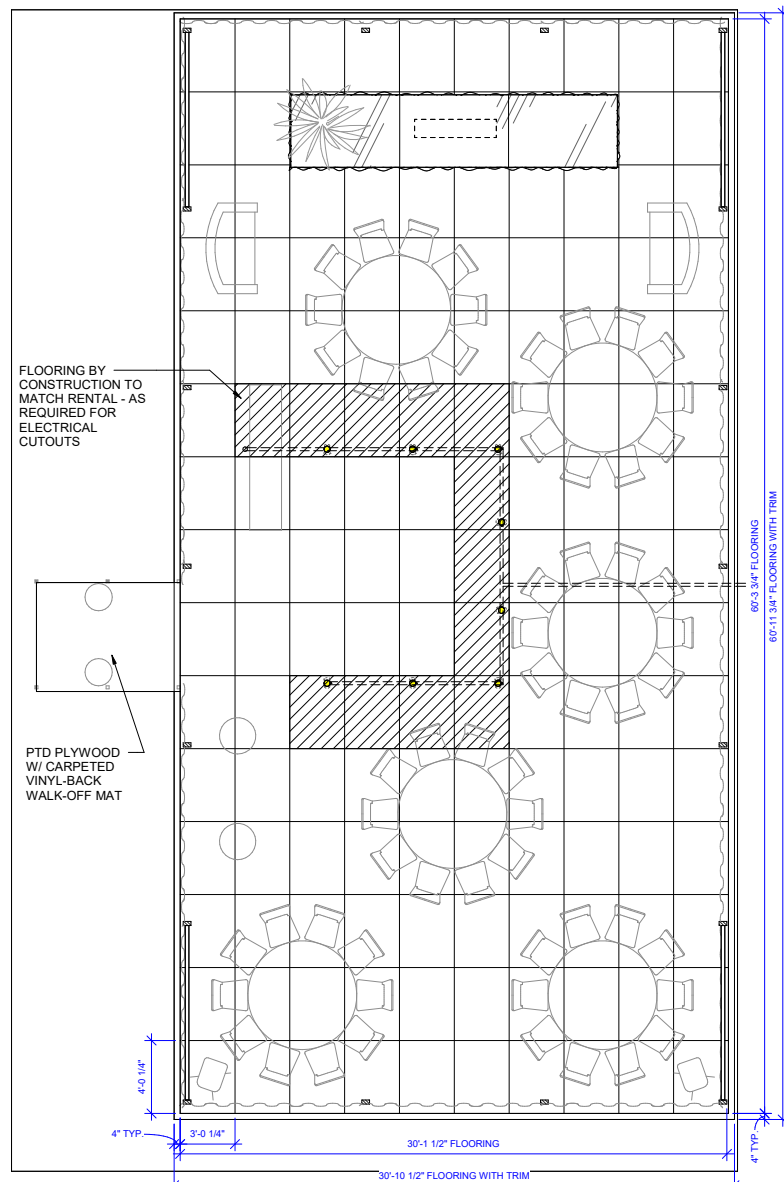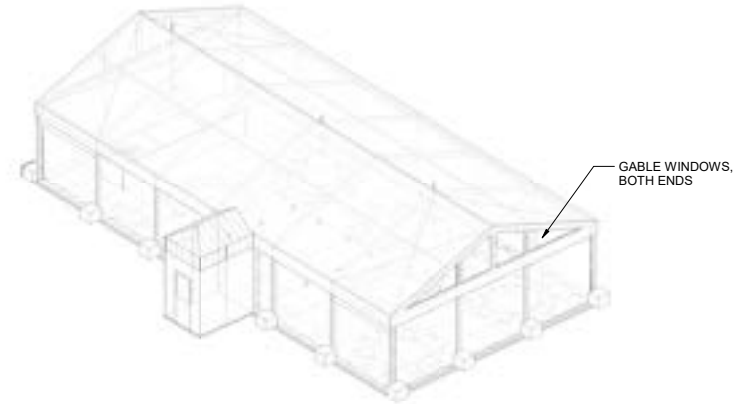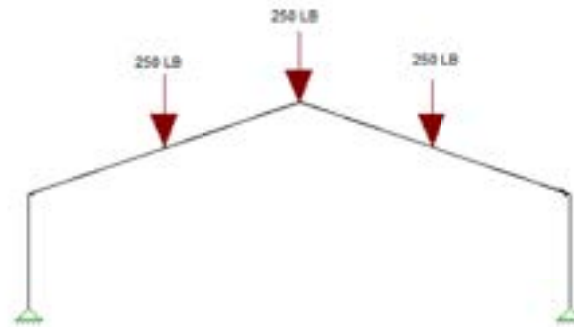

3 FLOORING PLAN
1/4" = 1'-0"

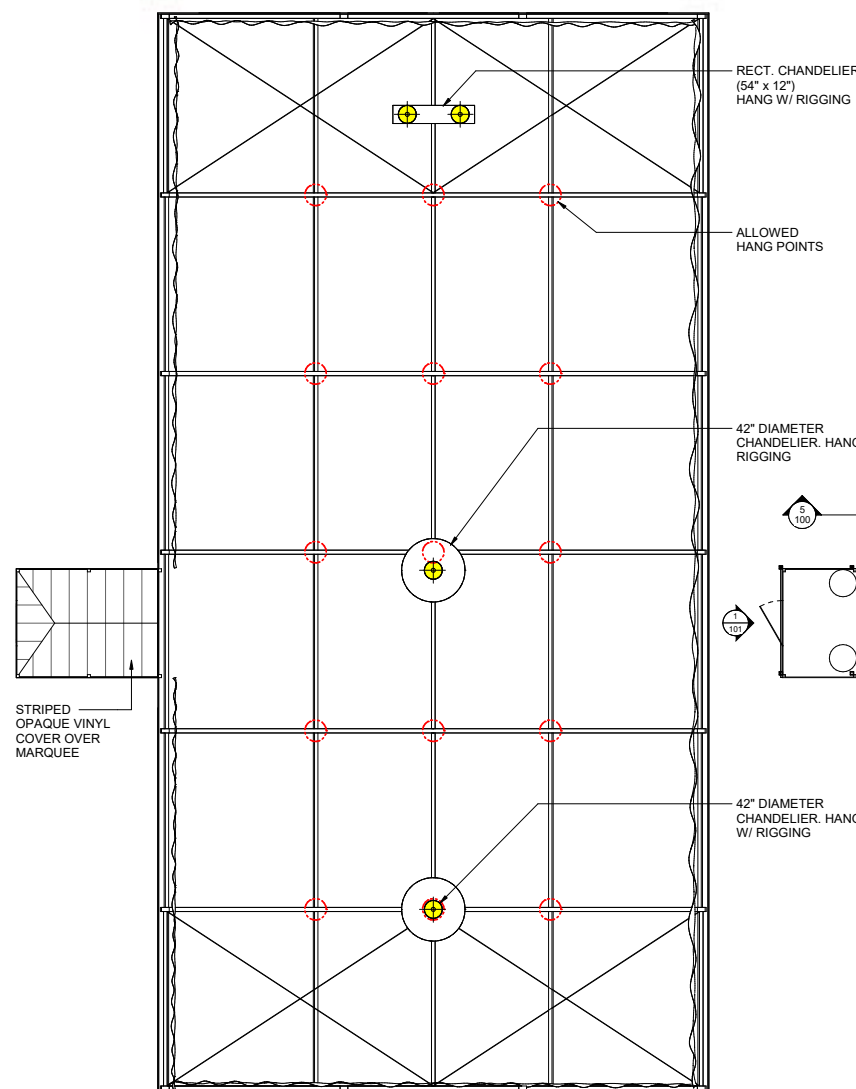

2 REFLECTED CEILING PLAN
1/4" = 1'-0"

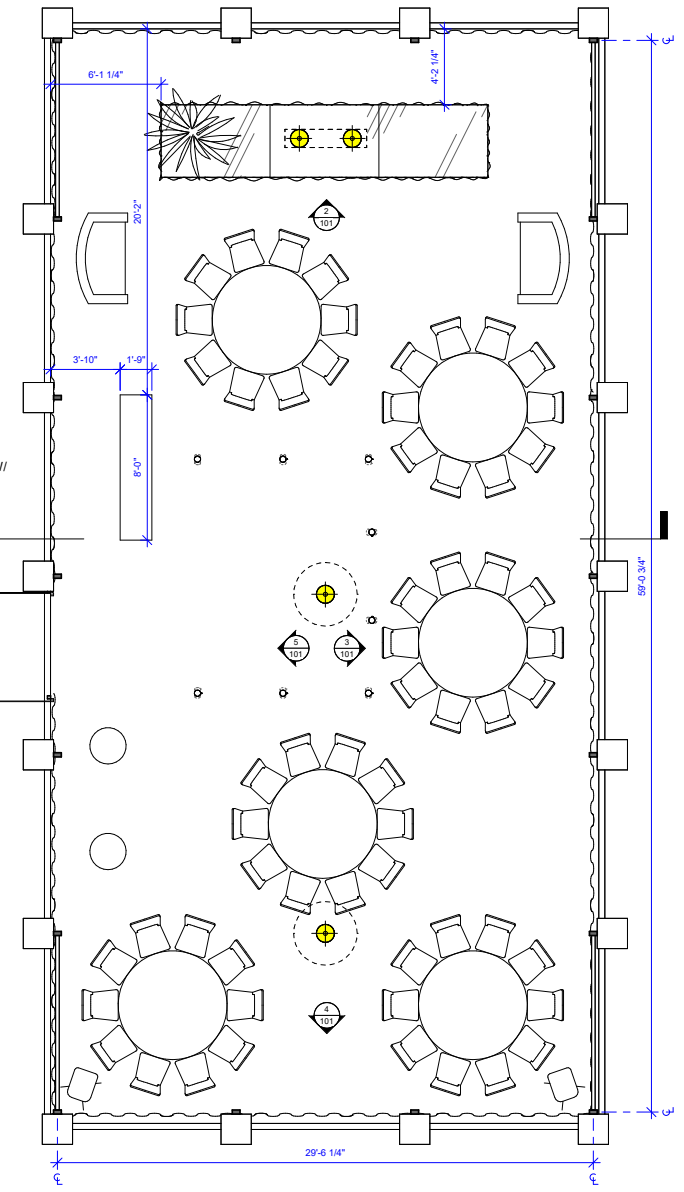

1 PLAN
1/4" = 1'-0"

RELOCATED FURN. AND CHANDELIERS, HANG W/ RIGGING
MAY 06 / 2024

THE BEAR
SEASON 3

REVISED
APR 17 / 2024


FINAL - AS BUILT
MAY 15 / 2024

director: CHRISTOPHER STORER
JOANNA CALO
production designer: MERJIE VESKI
art director: LISA KORPAN
set: EXT FRANK'S / TENT


drawing: PLANS AND SECTIONS

location: CINESPACE - STAGE 35
scale: 1/4" = 1'-0" drawn by: ANGELA NGO
date: 04.17.2024 block:
set no: sheet no:


404-43 100

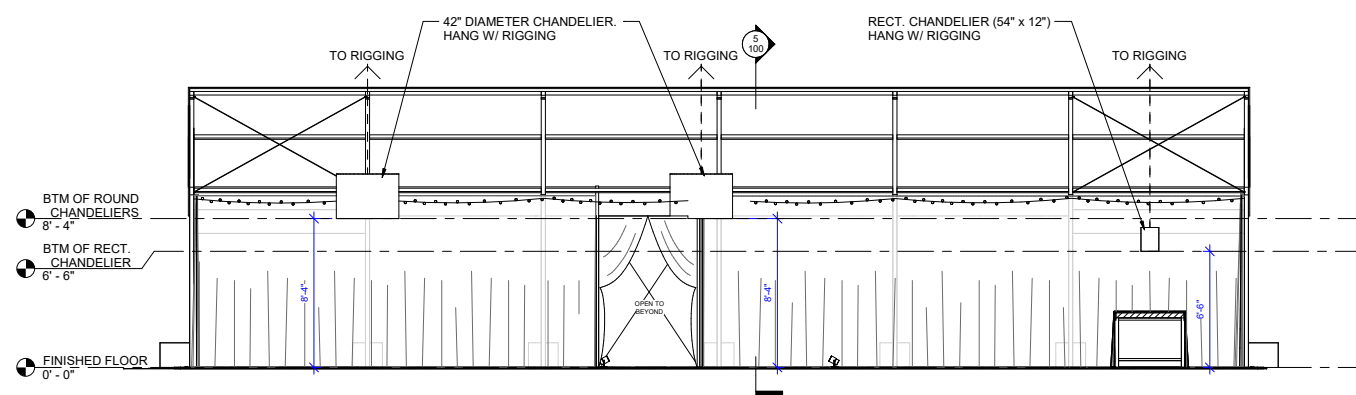


5 INTERIOR ELEVATION - WEST ENTRANCE
1/4" = 1'-0"

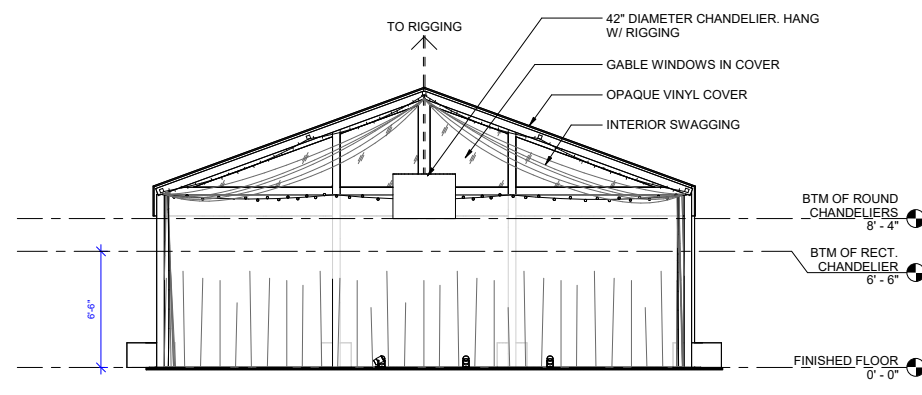


4 INTERIOR ELEVATION - SOUTH GABLE
1/4" = 1'-0"

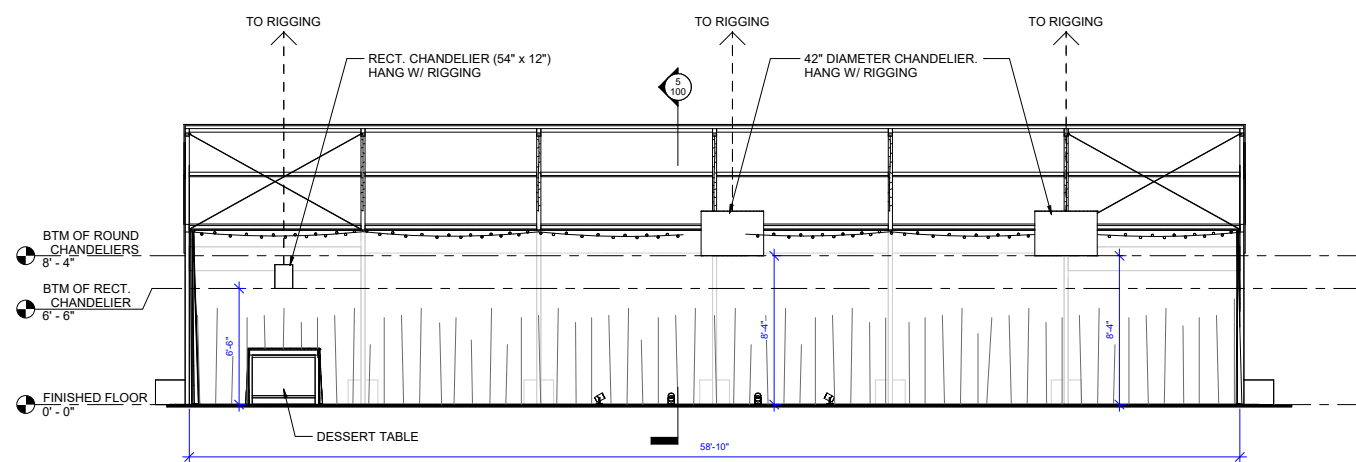

3 INTERIOR ELEVATION - EAST
1/4" = 1'-0"

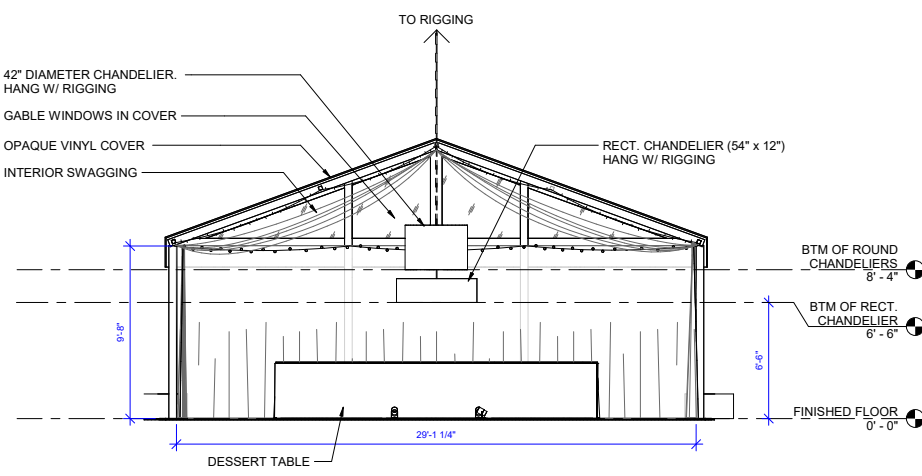

2 INTERIOR ELEVATION - NORTH GABLE
1/4" = 1'-0"

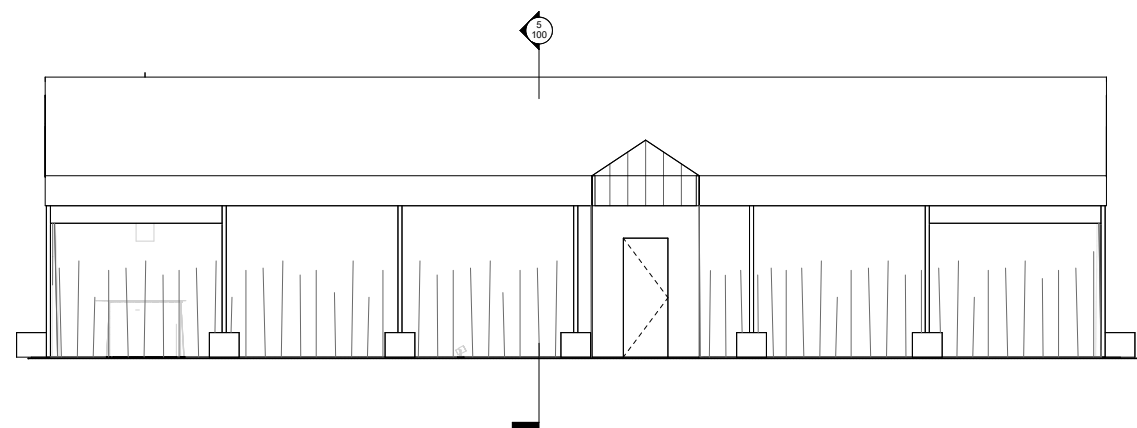

1 EXTERIOR ELEVATION - ENTRANCE
1/4" = 1'-0"

RELOCATED FURN. AND
CHANDELIERS. HANG W/
RIGGING
MAY 06 / 2024

THE BEAR
SEASON 3

RELEASED
APR 17 / 2024

FINAL - AS BUILT
MAY 13 / 2024

director:
CHRISTOPHER STORER
production designer:
MERJE VESKI

art director:
LISA KORPAN

set: EXT FRANK'S / TENT

drawing: ELEVATIONS

location:
CINESPACE - STAGE 35


scale:
1/4" = 1'-0"

date:
04.17.2024


set no:

sheet no:

404-43 101

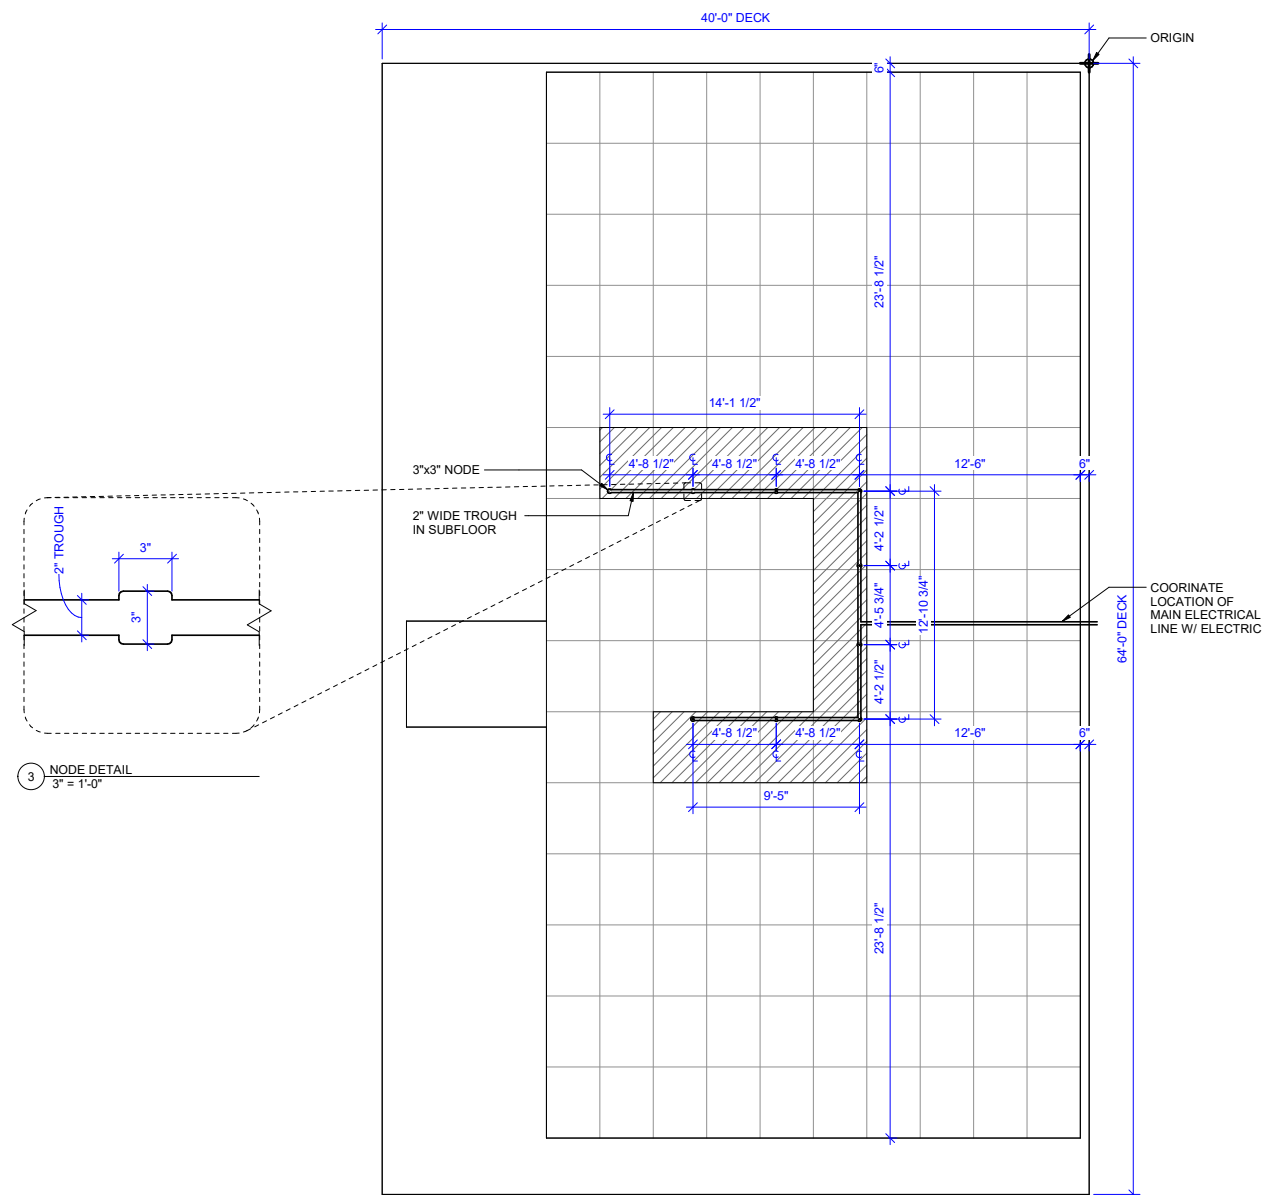

2 SUBFLOORING PLAN
1/4" = 1'-0"

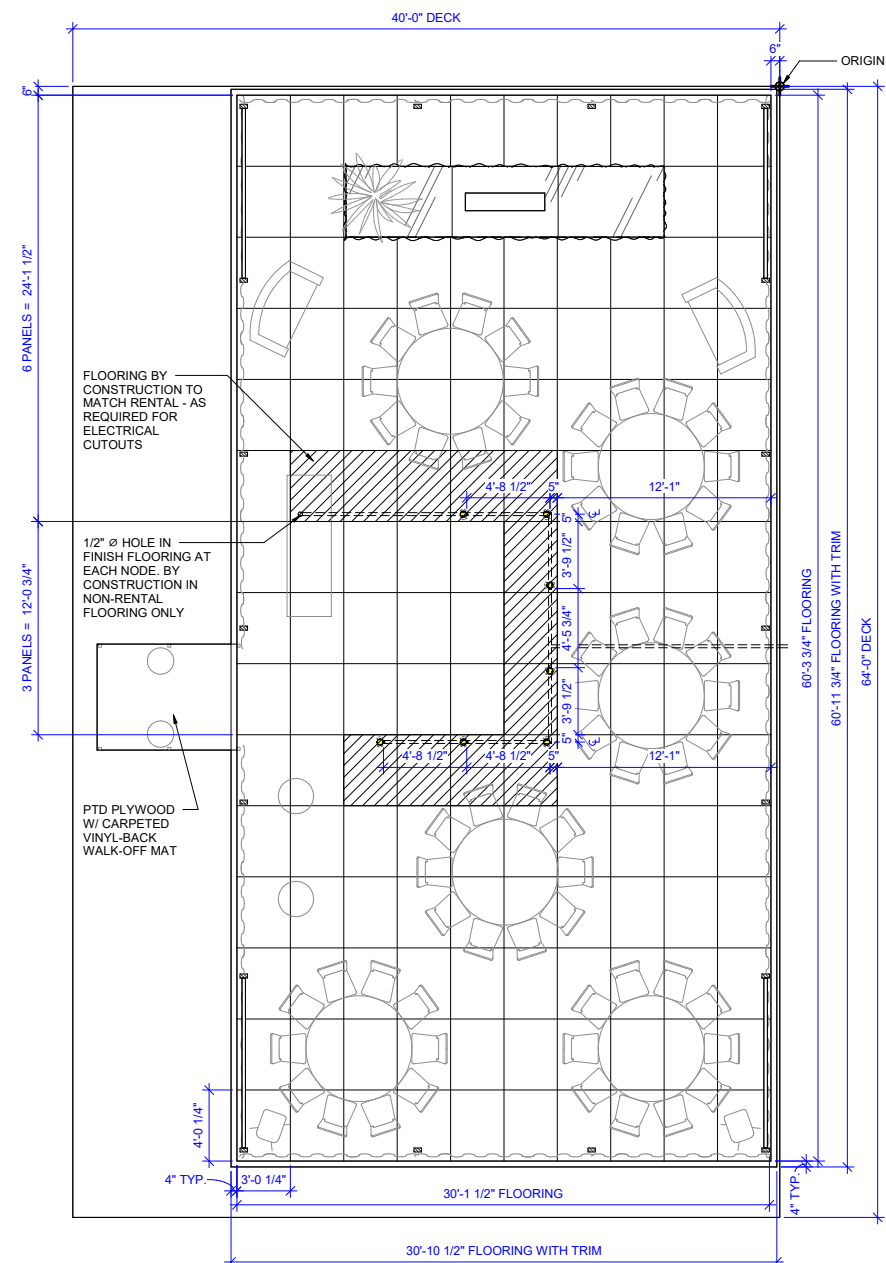

1 FINISH FLOORING PLAN
1/4" = 1'-0"

SET DEC:
DIRECTION OF FLOOR LIGHTS TO BE DETERMINED W/ DP & PD BEFORE SECURING TO FLOOR. COORDINATE W/ CONSTRUCTION BEFORE DRILLING (DRILL IN NON-RENTAL FLOORING ONLY)

THE BEAR
SEASON 3

RELEASED
APR 25 / 2024

FINAL - AS BUILT
MAY 14 / 2024

director:
CHRISTOPHER STORER
JOANNA CALO
production designer:
MERJE VESKI

art director:
LISA KORPAN

set: EXT FRANK'S / TENT

drawing: FLOORING PLANS

location:
CINESPACE - STAGE 35

scale:
As indicated

date:
04.25.2024

set no:
404-43

drawn by:
ANGELA NGO

block:
102

sheet no:



SET PHOTOS



SET PHOTOS



TENT - UNDER THE TABLE



RELEASED

MAR12 / 2024

THE BEAR

SEASON 3

Production Designer:
MERJE VESKI

Drawn by:
ANGELA NGO

Set name:
UNDER THE TABLE

Location address:
CINESPACE - STAGE 41

Scale:

Date:
03.12.2024

Block:

Scene no.:

Set no.:


404-45

Sheet no.:


500

Sheet name:
RENDERING - 4'-6" WIDE


EXT. FRANK'S TENT - UNDER THE TABLE

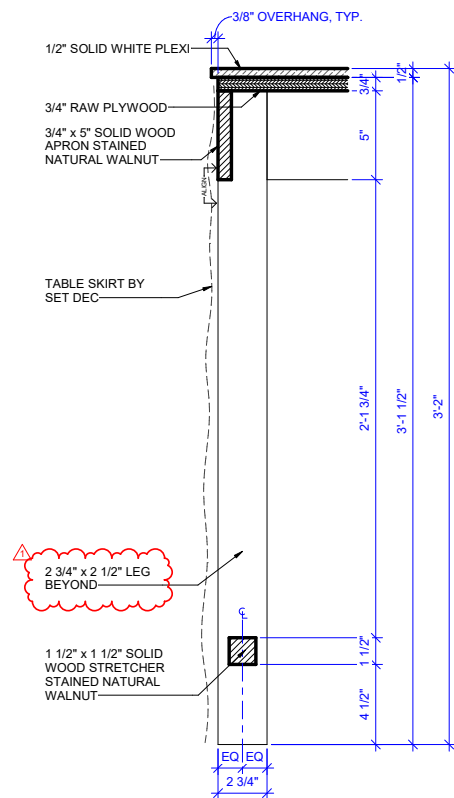


7 DETAIL SECTION
3" = 1'-0"

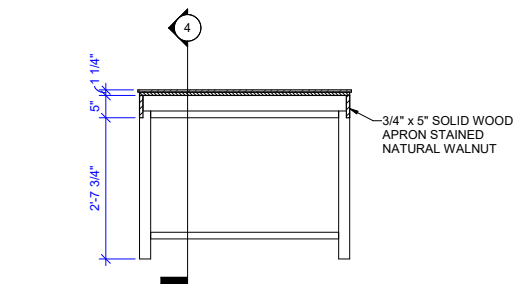


6 SECTION - TRANSVERSE
3/4" = 1'-0"

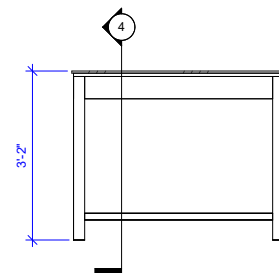


5 ELEVATION - LEFT/RIGHT
3/4" = 1'-0"

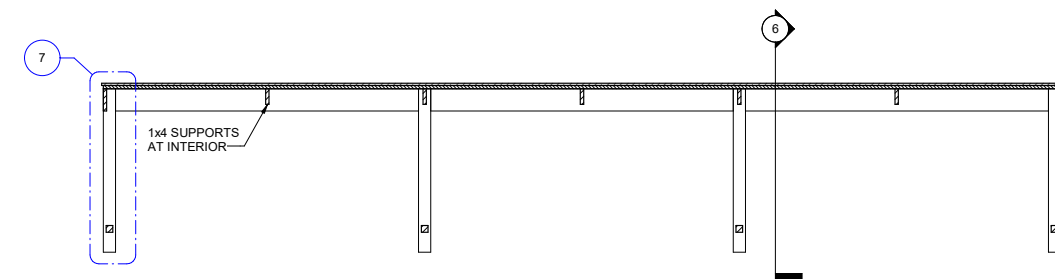


4 SECTION - LONGITUDINAL
3/4" = 1'-0"

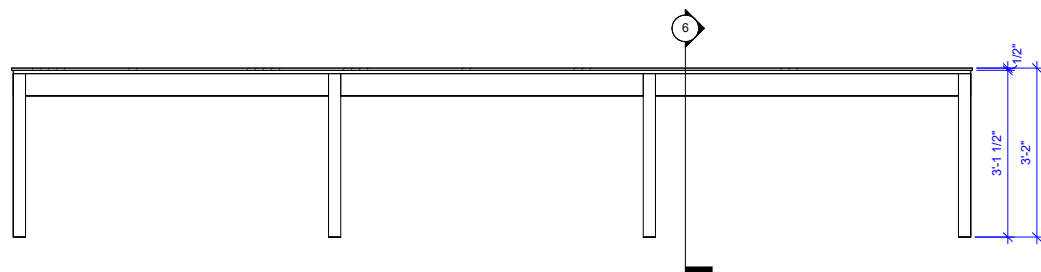


3 ELEVATION - FRONT/BACK
3/4" = 1'-0"

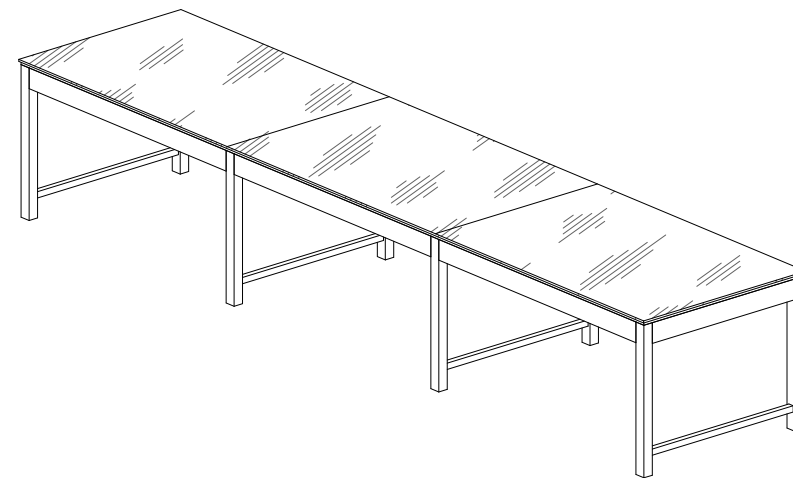

8 AXON

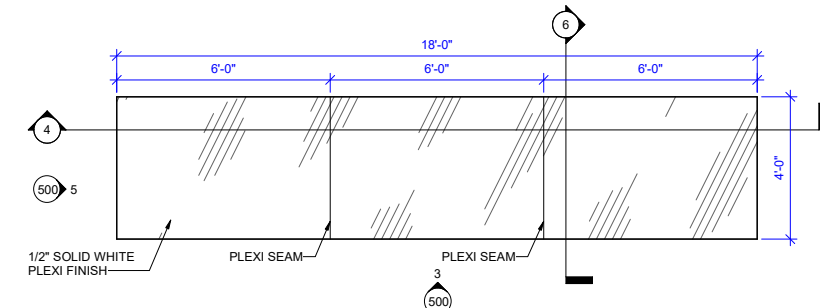

1 PLAN
1/2" = 1'-0"

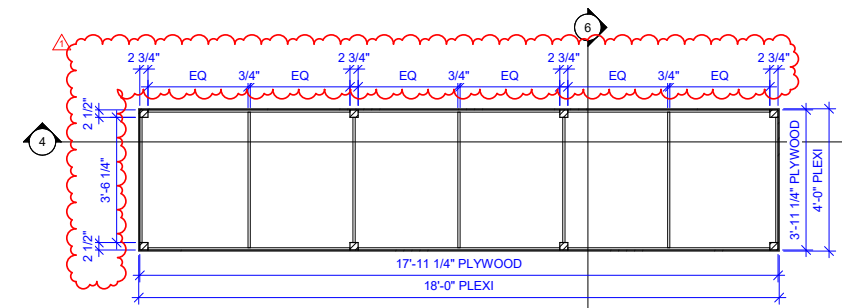

2 REFLECTED PLAN (UNDERSIDE OF TABLE)
1/2" = 1'-0"

THE BEAR
SEASON 3

REVISED
MAR 12/2024

UPDATED LEG DIMENSIONS
MAR 12 / 2024

director:
CHRISTOPHER STORER
JOANNA CALO
production designer:
MERJE VESKI

art director:
LISA KORPAN

set: EXT. FRANK'S HOUSE

drawing: TABLE DETAILS

location:
CINESPACE - STAGE 41

scale:
As Indicated

drawn by:
ANGELA NGO

date:
03.06.2024

block:

set no:

sheet no:

404-43 500

PRODUCTION DESIGNER
MERJE VESKI

ART DIRECTOR	LISA KORPAN
SET DECORATOR	ERIC FRANKEL
LEAD PERSON	JEFFREY R. KLEIN
SET DESIGNER	ANGELA NGO
PROPERTY MASTER	LAURA ROEPER

CREDITS ON SCREEN