

BEEF SEASON 2 // EPISODE 203 // INT. AUSTIN & ASHLEY APARTMENT





BEEF SEASON 2 // EPISODE 203 // INT. AUSTIN & ASHLEY APARTMENT






BEEF SEASON 2 // EPISODE 203 // INT. AUSTIN & ASHLEY APARTMENT

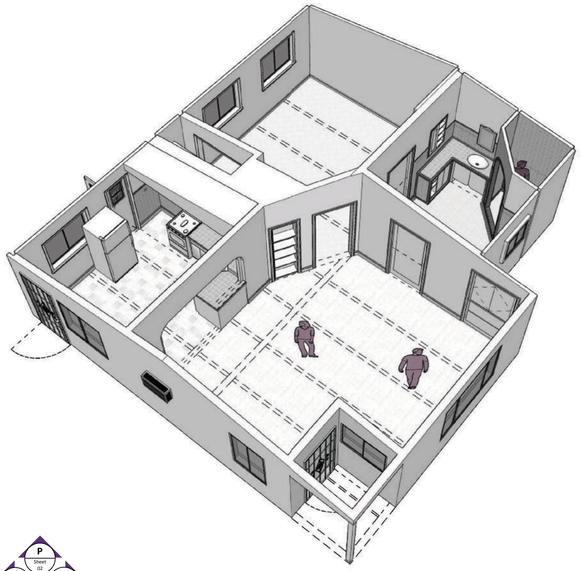


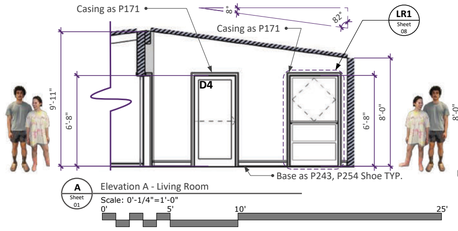


A Sheet 01 Elevation A - Living Room
Scale: 0'-1/4"=1'-0"
0' 5' 10' 25'

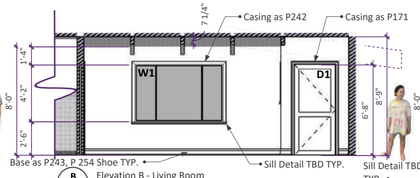


B Sheet 01 Elevation B - Living Room
Scale: 0'-1/4"=1'-0"

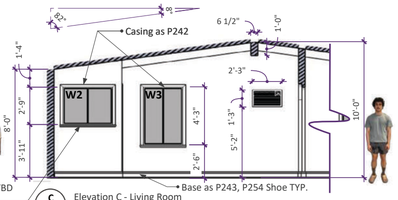


C Sheet 01 Elevation C - Living Room
Scale: 0'-1/4"=1'-0"

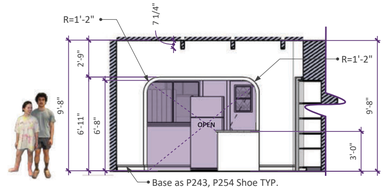


D Sheet 01 Elevation D - Living Room
Scale: 0'-1/4"=1'-0"

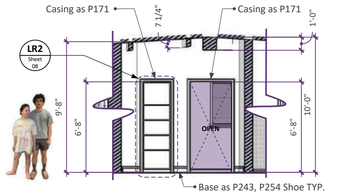


E Sheet 01 Elevation E - Living Room
Scale: 0'-1/4"=1'-0"

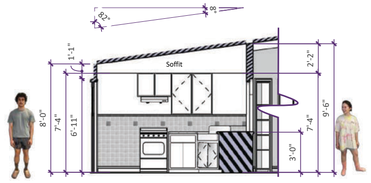


F Sheet 01 Elevation F - Kitchen
Scale: 0'-1/4"=1'-0"

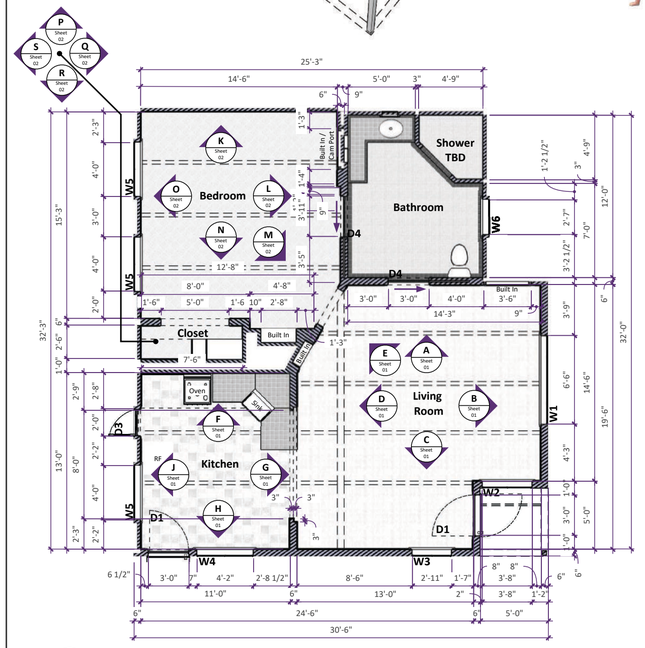


PL1 Sheet 01 Int. Ashley and Austin's Apt.
Scale: 0'-1/4"=1'-0"
0' 5' 10' 25'

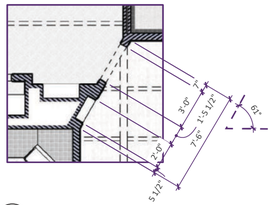


PL2 Sheet 01 Int. Ashley and Austin's Apt. - Angled Wall for Clarity
Scale: 0'-1/4"=1'-0"
0'

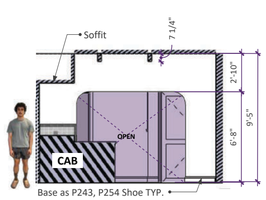

G Sheet 01 Elevation G - Kitchen
Scale: 0'-1/4"=1'-0"

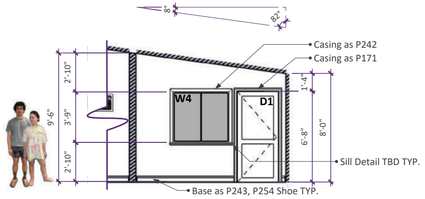

H Sheet 01 Elevation H - Kitchen
Scale: 0'-1/4"=1'-0"

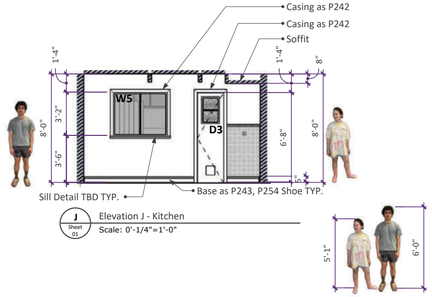

J Sheet 01 Elevation J - Kitchen
Scale: 0'-1/4"=1'-0"

1 REVISED 01/06/25
As Built Updates for Records

Scale Check: 1"
"If this is not 1", this drawing has been printed incorrectly"

V.06 - 01/06/25
9:30 AM

BEEF S2

Production Designer: Grace Yun	Art Director: AJ Cisneros		
Set Set Decorator: Michael Hersey	Set Designer: Brandon Hake		
Construction Coord.: Ryan Handt			
Assistant to Theron: Kaitlin St Thomas			
Set Name: Int. Austin and Ashley's Apt.		AMORT	
Drawing: Plan / Elev		Set #:151-155	Sheet Number: 01 of 14
Location: Stage 12 - Radford Studios 1041 Cahuenga Blvd		Date: 01/06/25	
Drawn By: B.Hake - 5857090335		Scale: As Noted	

THIS DRAWING REPRESENTS VISUAL CONCEPTS ONLY. IF NECESSARY, CONSULT A QUALIFIED ENGINEER FOR STRUCTURAL APPROPRIATENESS. FOLLOW APPLICABLE FIRE & SAFETY CODES. DIMENSIONS TAKE PRECEDENCE OVER DRAWING.
CONFIDENTIALITY STATEMENT: THIS IS CONFIDENTIAL INFORMATION INTENDED ONLY FOR "BEEF" PERSONNEL. IF YOU RECEIVED THIS DOCUMENT IN ERROR, PLEASE NOTIFY US & RETURN OR DESTROY IT.


BEEF SEASON 2 // EPISODE 203 // INT. AUSTIN & ASHLEY APARTMENT





BEEF SEASON 2 // EPISODE 203 // INT. COUNTRY CLUB BANQUET HALL



BEEF SEASON 2 // EPISODE 203 // INT. COUNTRY CLUB BANQUET HALL

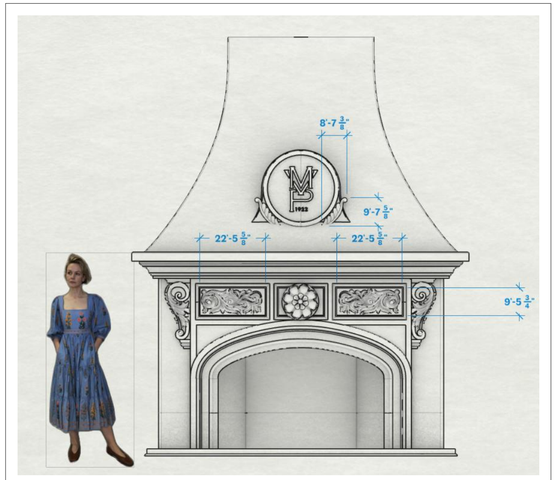

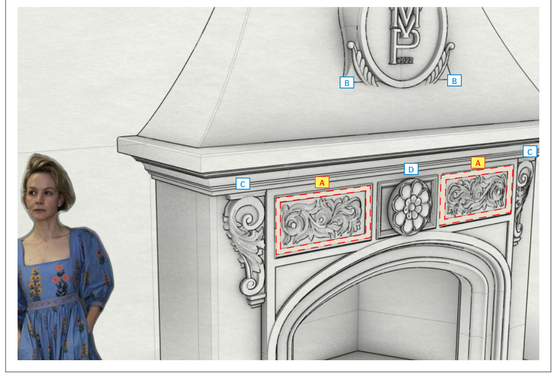


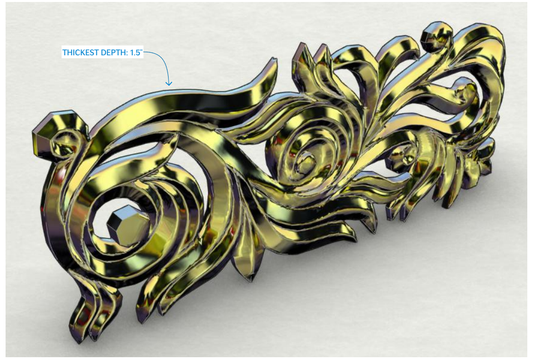






BEEF SEASON 2 // EPISODE 203 // INT. COUNTRY CLUB

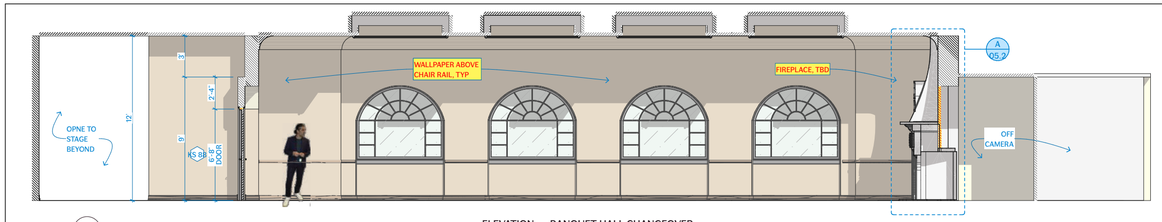


A ELEVATION — BANQUET HALL CHANGEOVER

SCALE: 1/4" = 1'-0"

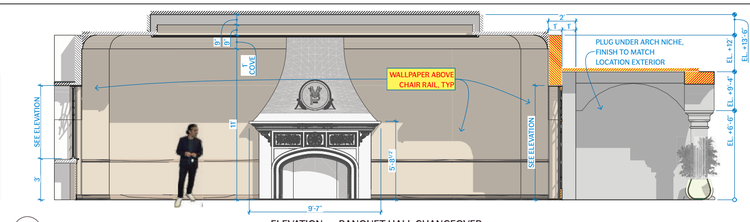


B ELEVATION — BANQUET HALL CHANGEOVER

SCALE: 1/4" = 1'-0"

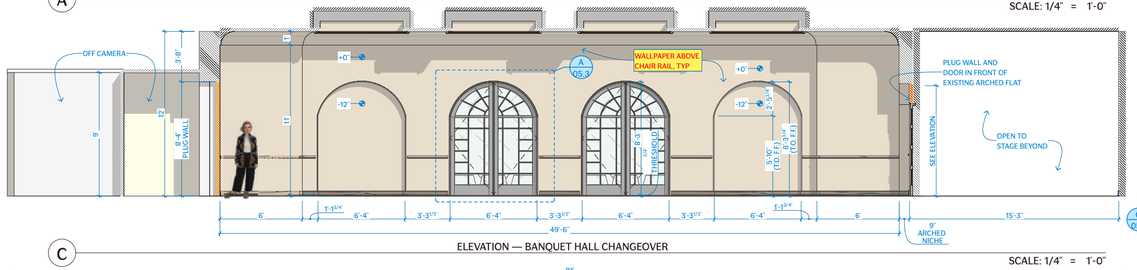


C ELEVATION — BANQUET HALL CHANGEOVER

SCALE: 1/4" = 1'-0"

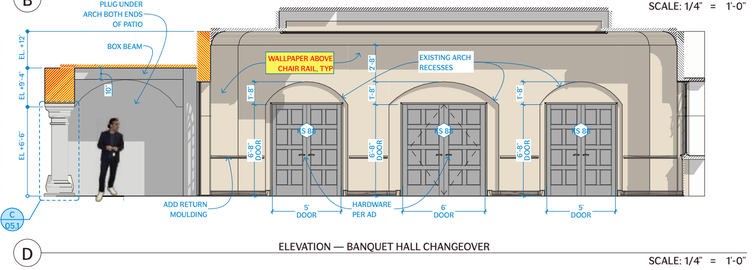


D ELEVATION — BANQUET HALL CHANGEOVER

SCALE: 1/4" = 1'-0"

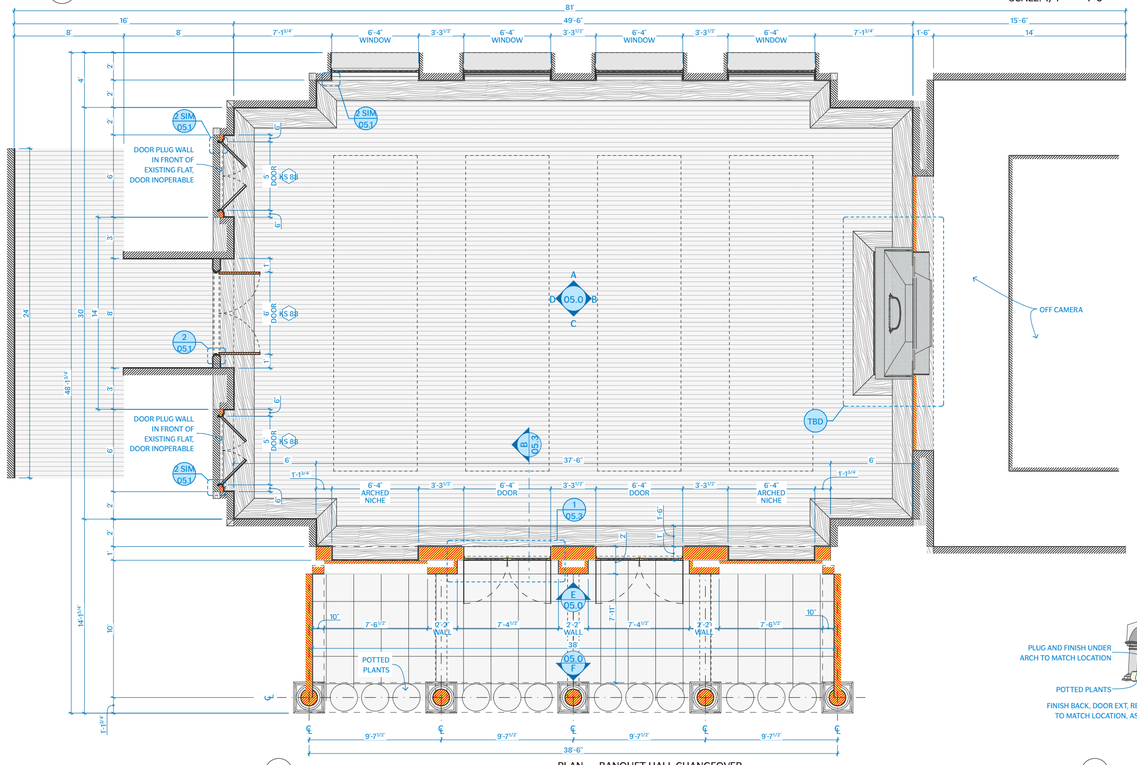


1 PLAN — BANQUET HALL CHANGEOVER

SCALE: 1/4" = 1'-0"

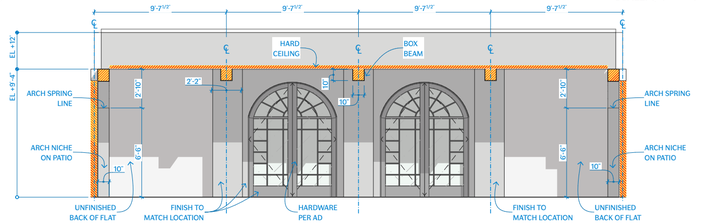


E ELEVATION — BANQUET HALL CHANGEOVER — PATIO NORTH

SCALE: 1/4" = 1'-0"

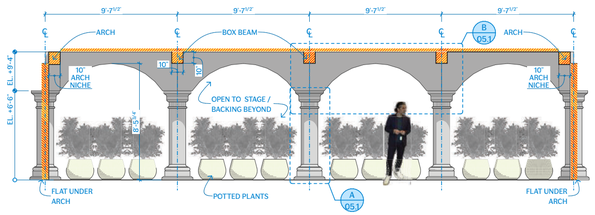

F ELEVATION — BANQUET HALL CHANGEOVER — PATIO SOUTH

SCALE: 1/4" = 1'-0"

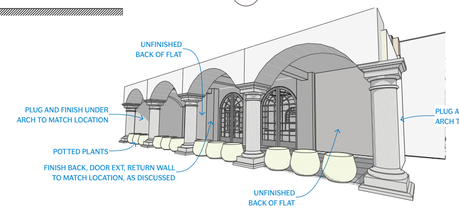

2 PERSPECTIVE — BANQUET HALL PATIO

KEY

BANQUET HALL

EXISTING CONSTRUCTION

Scale Check: 1"

"If this is not 1", this drawing has been printed incorrectly"

IE COUNTRY CLUB

PRELIMINARY

SDMM AIA ASSOC

BEEF S2

Production Designer: Grace Yun
Sup. Art Director: Michael Hersey
Construction Coord.: Ryan Handt
Set Designer: Nalini Jo Tinney
Art Director: AJ Cisneros
Set Designer: Keene Kopper

Set Name:	INT BANQUET HALL		AMORT
Drawing:	PLAN, ELEVS, 3D — BANQUET CHANGEOVER	Set #:	108
Location:	STAGE 10	Date:	1/21/25
Drawn By:	Keene Kopper	Scale:	As Noted

Sheet Number: 05.0

Printed: 1/21/25 2:51 PM
Tuesday, January 21, 2025
SHEET SIZE: 24 x 36

THIS DRAWING REPRESENTS VISUAL CONCEPTS ONLY. IF NECESSARY, CONSULT A QUALIFIED ENGINEER FOR STRUCTURAL APPROPRIATENESS. FOLLOW APPLICABLE FIRE & SAFETY CODES. DIMENSIONS TAKE PRECEDENCE OVER DRAWING. CONFIDENTIALITY STATEMENT: THIS IS CONFIDENTIAL INFORMATION INTENDED ONLY FOR "BEEF" PERSONNEL. IF YOU RECEIVED THIS DOCUMENT IN ERROR, PLEASE NOTIFY US & RETURN OR DESTROY IT.

BEEF SEASON 2 // EPISODE 203 // INT. COUNTRY CLUB BANQUET HALL




BEEF SEASON 2 // EPISODE 203 // INT. COUNTRY CLUB OFFICES




BEEF SEASON 2 // EPISODE 203 // INT. COUNTRY CLUB OFFICES



BEEF SEASON 2 // EPISODE 203 // INT. COUNTRY CLUB OFFICES

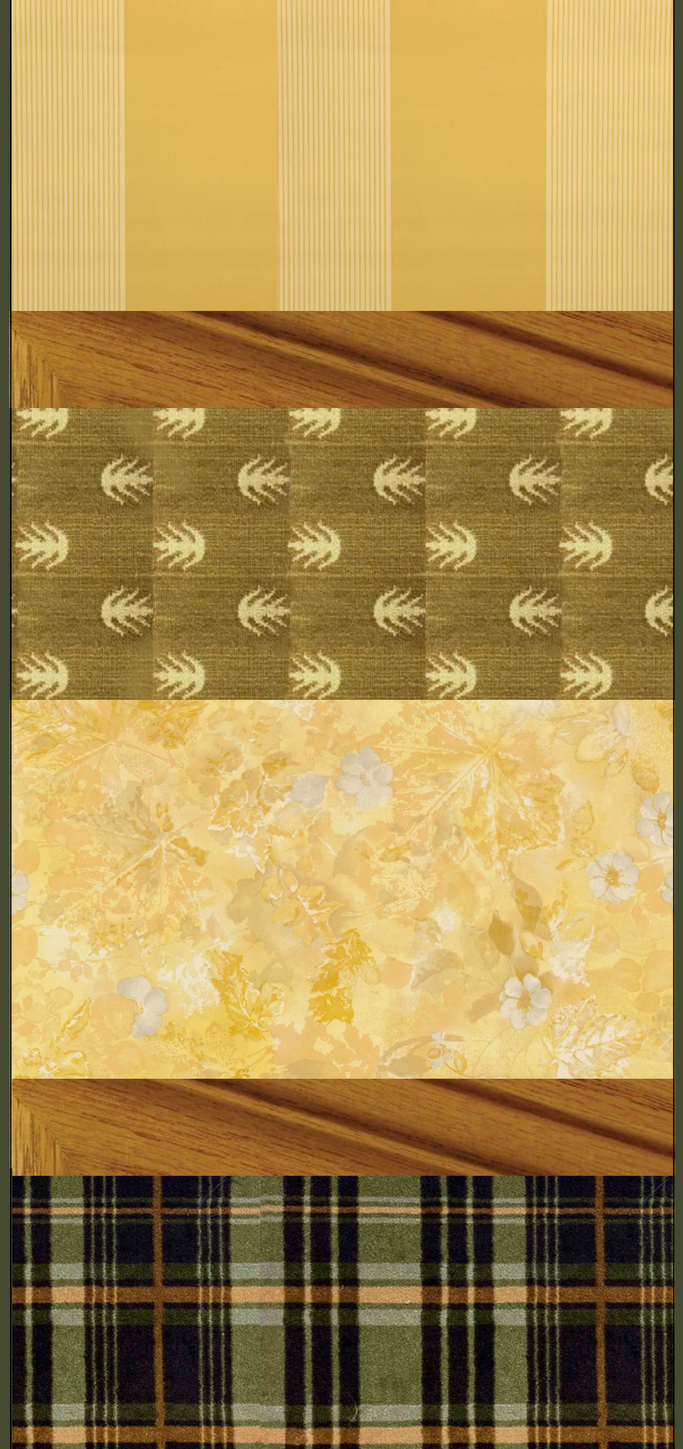

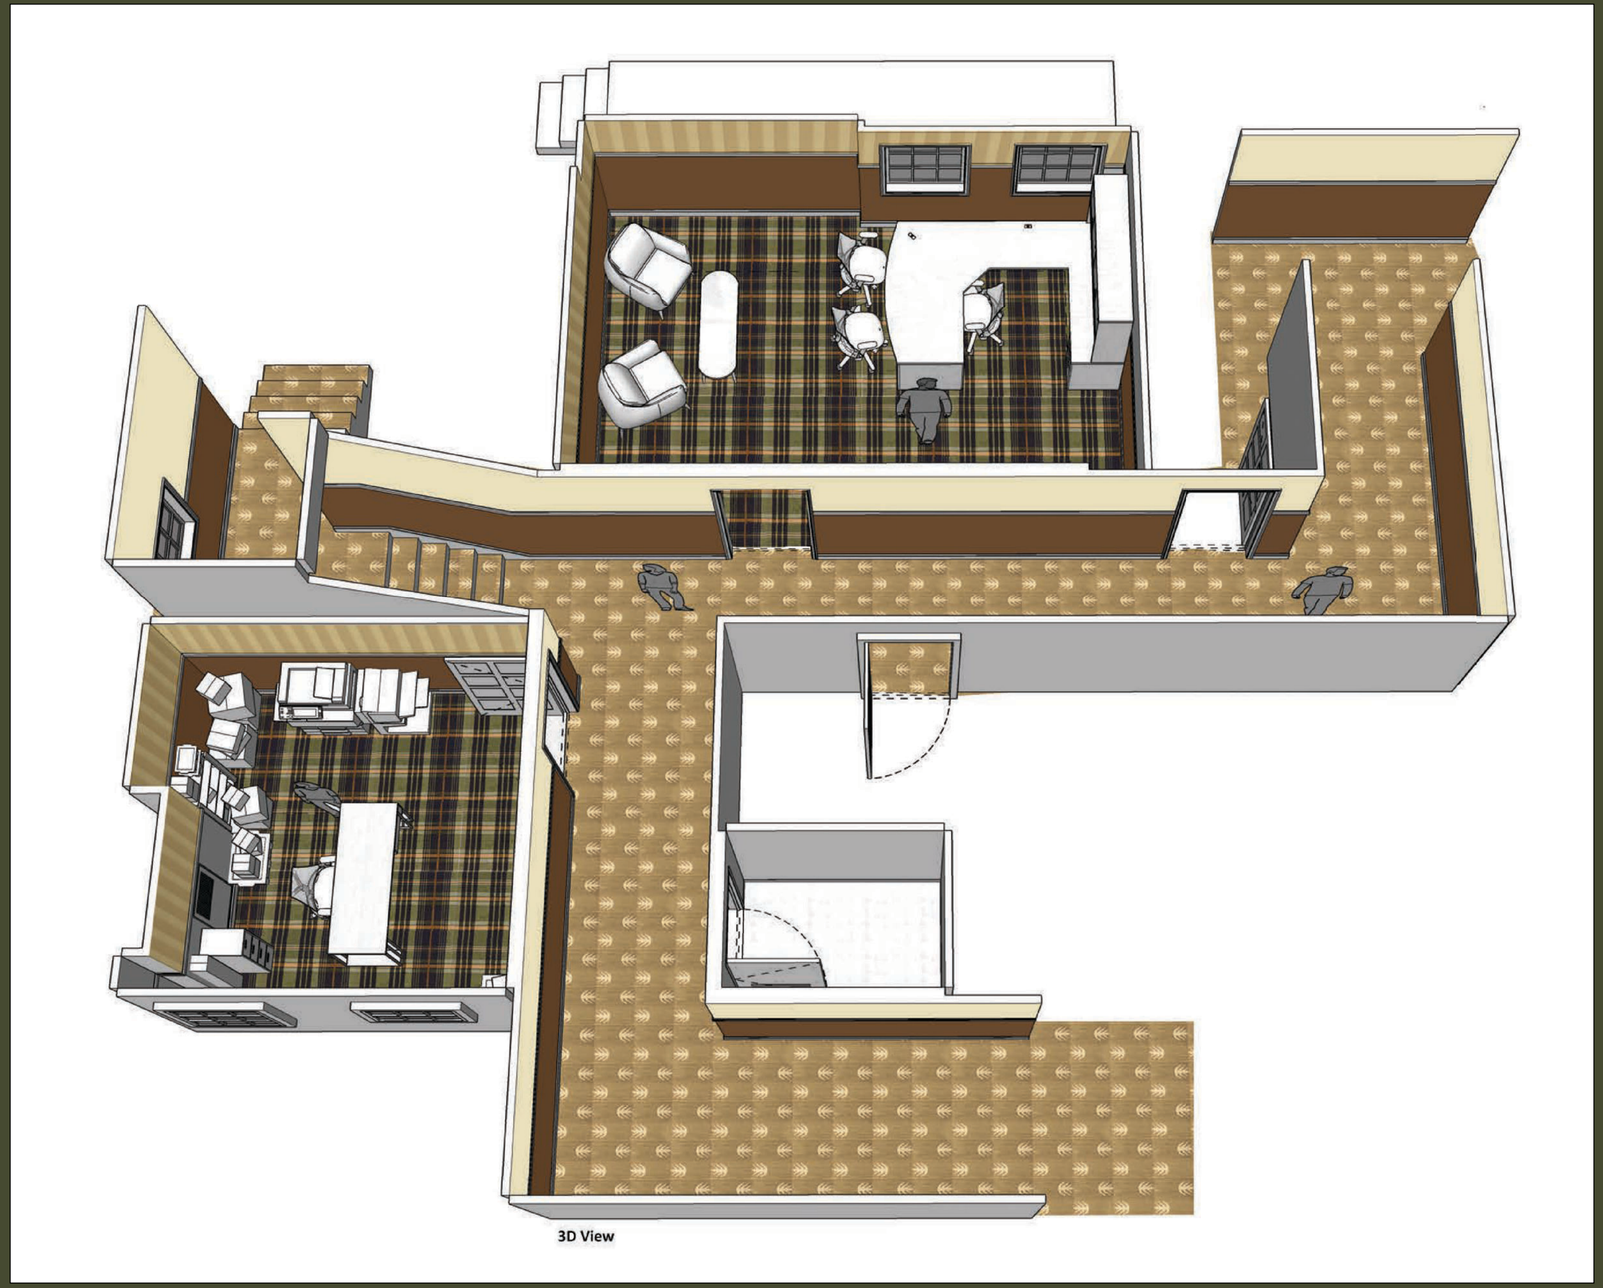

3D View



BEEF SEASON 2 // EPISODE 203 // INT. JOSH & LINDSAY'S HOUSE







BEEF SEASON 2 // EPISODE 203 // INT. JOSH & LINDSAY'S HOUSE



BEEF SEASON 2 // EPISODE 203 // INT. JOSH'S ADU






24
BANG & OLUFSEN
BANG & OLUFSEN



BEEF SEASON 2 // EPISODE 203 // INT. TROCHOS CLINIC






BEEF SEASON 2 // EPISODE 203 // INT. TROCHOS CLINIC


수술센터
SURGERY CENTER
대기실





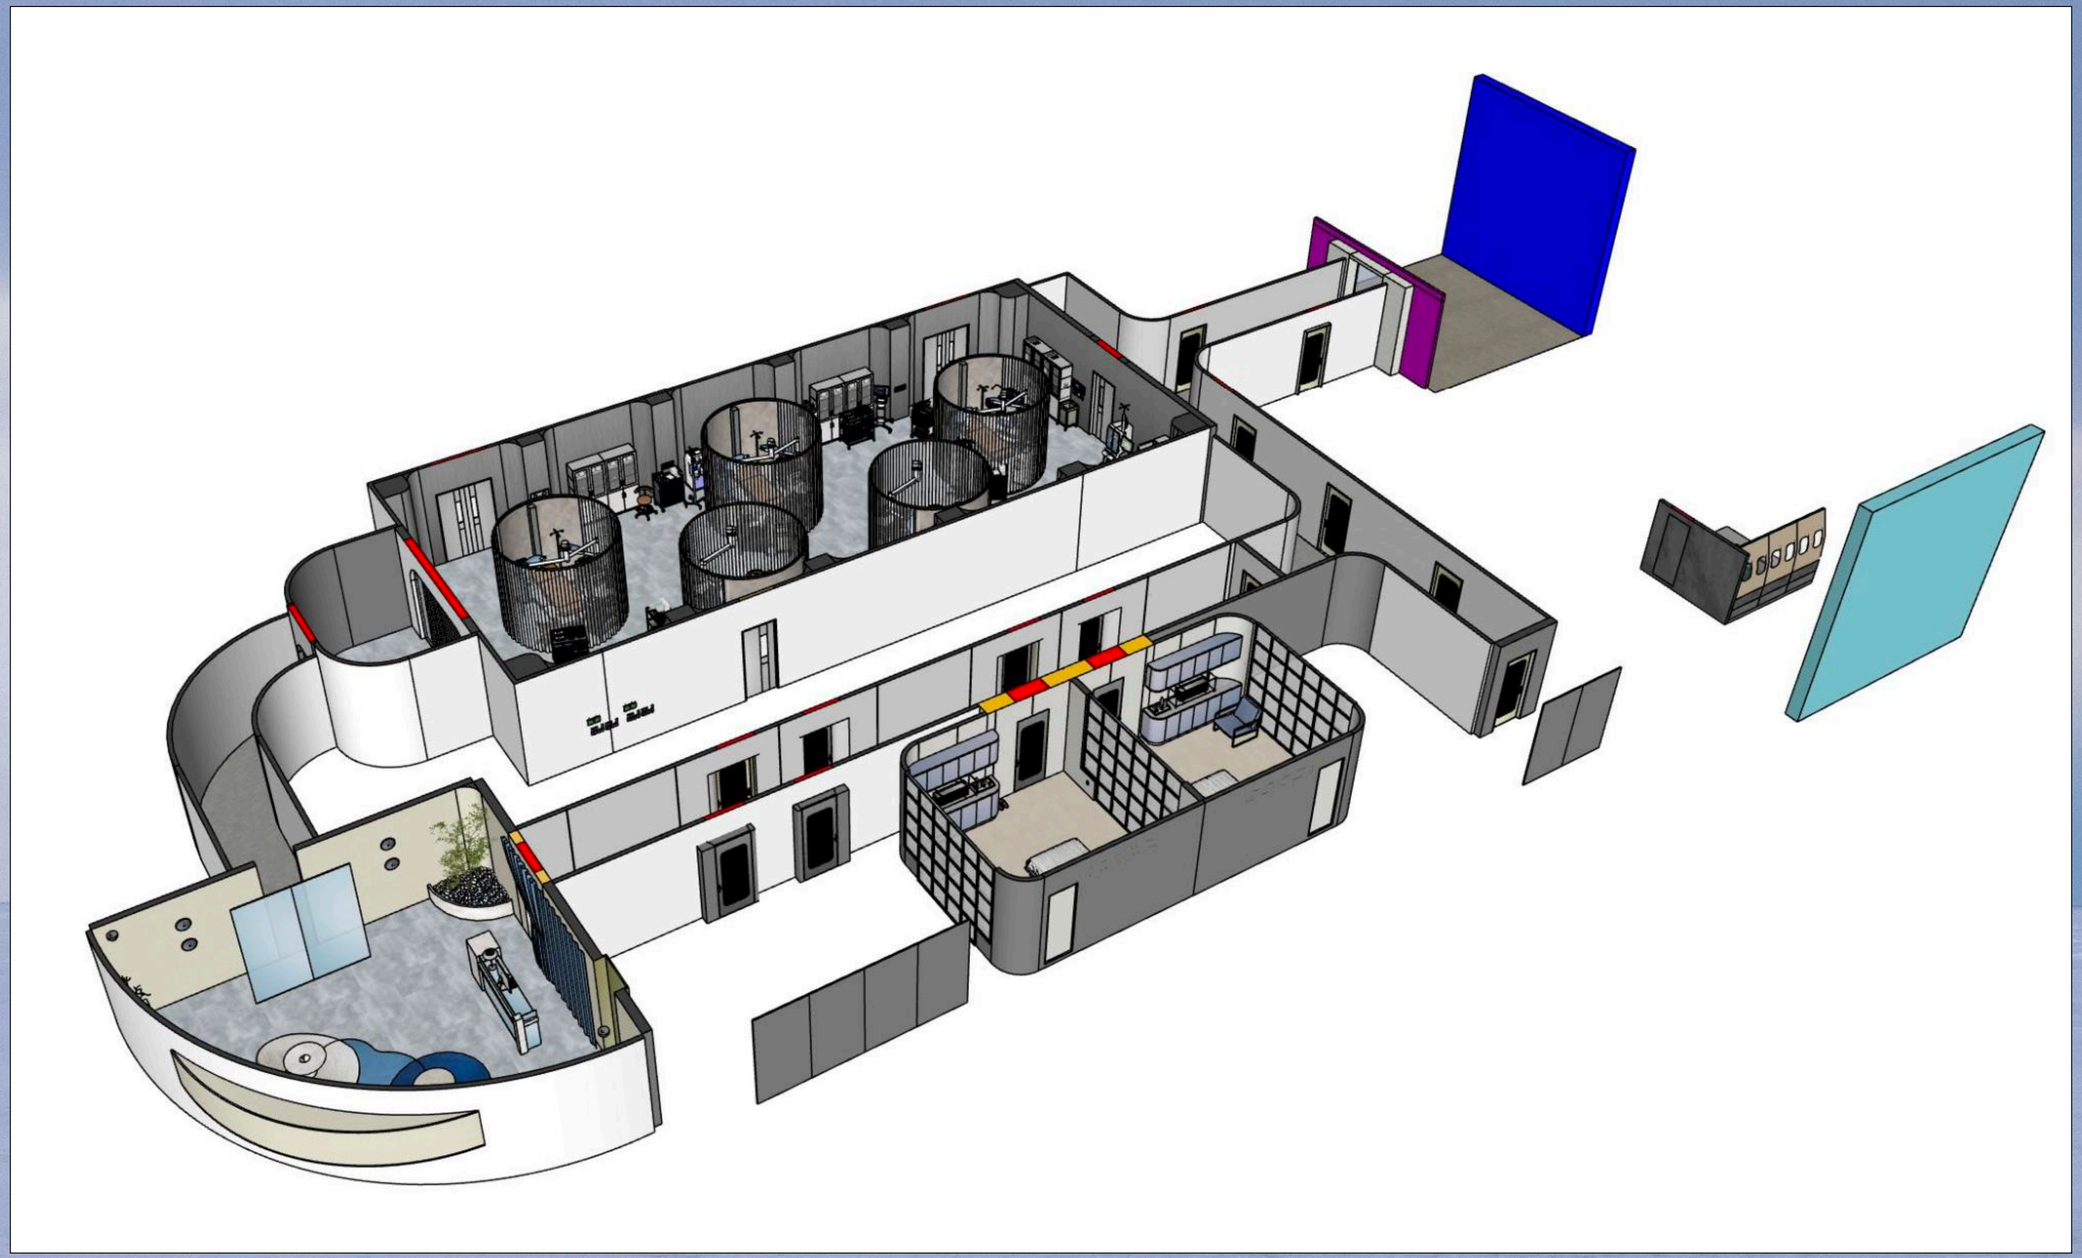

BEEF SEASON 2 // EPISODE 203 // INT. TROCHOS CLINIC